U.S. Department of Transportation **Federal Aviation** 

# **MAJOR REPAIR AND ALTERATION** (Airframe, Powerplant, Propeller, or Appliance)

Form Approved OMB No. 2120-0020 For FAA Use Only

Office Identification 9/GAC

Federal Aviation Administration SOCIA00311036 SU-09/GAC INSTRUCTIONS: Print or type all entries, See FAR 43.9, FAR 43 Appendix B, and AC 43.9-1 (or subsequent revision thereof) for instructions

			ort is required by l Federal Aviation A			C. 1421). Failui	e to report	can result in a civil	penalty no	ot to exceed \$	51,000.00	
1. Aircraft	Make Cessna					Model C-177RG						
1. AllGalt	Serial No. 177-RG-1259						Nationality and Registration Mark USA			k N516AP		
2. Owner	Name (As shown on registration certificate) Carper, William B				Address (As shown on registration of 10011 Autumn Lane Pensacola, FL 32514				certificate)			
	r <b>equir</b> e	men	ts and is appr ity inspection JUN	oved by a 09	for pers 200	the above of son authorized 3	lescribed of in FAR	aircraft, subje	ct 3.7:"	FSD <b>O-09</b>		
Unit		Make		it Ide	is <b>y</b> al	Model	sture of	FAA inspector Serial No	).	5. <b>Type</b> Repair	Alteration	
AIRFRAME	~~~~~~ (As de:			scribed in Item 1 above ) ~~~~~~~~				-	х			
POWERPLAN	·											
PROPELLER												
APPLIANCE	Type Manufacturer											
nemer som i sem bestemt i entrementeren et til mennen fra sk					6. <b>C</b>	onformity Stat	ement			+		
A. Agency's Name and Address  Blue Angel Aviation 2401 Executive Plaza Rd Suite 8-A Pensacola, FL 32504  D. I certify that the repair and/or alteration made to the unit(s)				X	Foreign Certific Certificated Re Manufacturer ified in item 4 a	cated Mechanic  rtificated Mechanic  Repair Station  er  B4UR140N  Class I,II,III  (LIM),AF(LIM)			reto			
			th the requirement to the best of m				deral Aviatio	on Requiations and	tnat the ir	itormation		
Date 06/0	9/2003					nature of Author	ized Individu					
				- <del>7.</del>		oval For Return	To Servic	e				
			sons specified bel		unit	identified in iten		ected in the mann	er prescrib	ed by the		
Ins	A FIt Standards		Manufacturer		Insp	pection Authoriz		Other (Specify	y)			
BY	A Designee	х	Repair Station		1	son Approved b	•					
Date of Approval or Rejection  06/09/2003  Certificate or Designation No.  PALID 140N				Signature of Authorized Individual								
05/09/2003 B4UR140N			Clayton Caessens 2627453									

LETISE FANE

### **NOTICE**

Weight and balance or operating limitation changes shall be entered in the appropriate aircraft record. An alteration must be compatible with all previous alterations to assure continued conformity with the applicable airworthiness requirements.

#### 8. Description of Work Accomplished

(If more space is required, attach additional sheets. Identify with aircraft nationality and registration mark and date work completed.)

1. Introduction

Removed the following:

Pilots original .050" thick instrument panel

Installed the following:

New 0.090" Pilots instrument panel. New overlay panels for the lower instruments, and the co-pilots side panel.

2. Description

Modified the pilots instrument panel area IAW drawing ABR-004. Installed the new instrument panel utilizing the existing nutplates. Installed the new overlay panel on the lower instruments, and installed the co-pilots overlay panel. Installed the yoke and instrument mounts.

- 3. Control and operation: NA
- 4. Servicing: NA
- Maintenance Instructions

No re-curring maintenance is specified by the manufacture. All equipment will be inspected IAW FAR 43, appendix D.

were the company of the contract of the

Troubleshooting Information

Refer to a qualified maintenance facility

Removal And Replacement Information

All components can be removed and replaced using common tools and practices.

8. Diagrams

ABR-001, ABR-002, ABR-003, ABR-004, ABR-005

Special Inspection Requirements

NA

10. Application of Protective treatments

NA

11. Data

Drawings ABR-110, ABR-002, ABR-003, ABR-004, ABR-005, AC 43.13-1B

- List of Special Tools: NA
- For Commuter Category Aircraft: NA
- 14. Recommended overhaul periods

None specified

15. Airworthiness Limitations

NA

16. Revisions


In the event that these Instructions for Continued Airworthiness need to be revised, a letter will be submitted to the local FAA FSDO with a copy of the revised 337 describing the revision requirements.

SO-09/GAC JUN 0 9 2003

Additional Sheets are Attached 3-7 Affached


### NOTES:

- 1. ORIGINAL STRUCTURE .050" THICK
- 2. \* = FACTORY ATTACH POINTS FOR REMOVABLE PANEL
- 3. \*\* = FACTORY ATTACH POINTS FOR ORIGINAL CONTROL COLUMN MOUNT

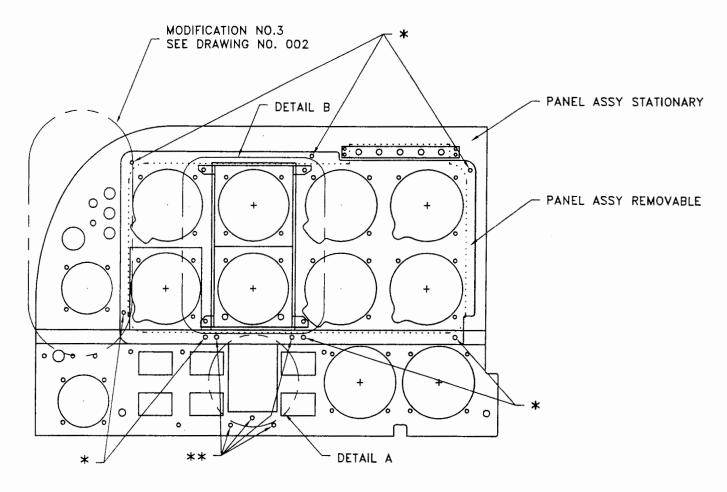


## EXISTING PANEL LAYOUT

4007816 Canada Inc. Aircraft Panel.Com 4920 Route de l'aeroport	SCALE: 1:4 & AS NOTED	EXISTING	PANEL	DRAWING NO. ABR-001	
St-Hubert, Quebec Canada, J3Y 8Y9 Tel: (514) 298-3343	DATE: 04/23/03	AIRCRAFT MODEL: CESSNA 177	DRAWN BY:	UTRAS	SHEET 1

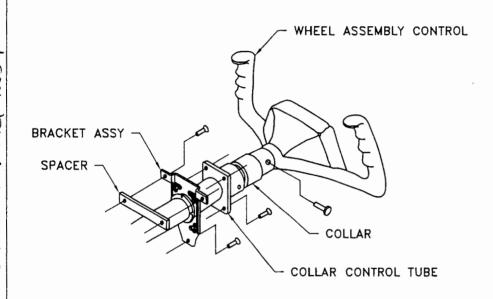

DETAIL A
MODIFICATION NO.1
SEE DRAWING NO. 002

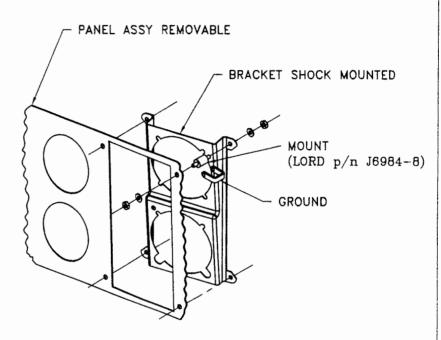



<u>DETAIL B</u>

MODIFICATION NO.2


SEE DRAWING NO. 002


4007816 Canada Inc. Alreraft Panel.Com 4920 Route de l'aeroport	SCALE: 1 : 4 & AS NOTED	EXISTING PANEL	DETAILS) ABR-		
St-Hubert, Quebec Canada, J3Y 8Y9 Tel: (514) 298-3343	DATE: 04/23/03	AIRCRAFT MODEL: CESSNA 177	DRAWN BY: S. JUTRAS	SHEET 1	

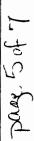

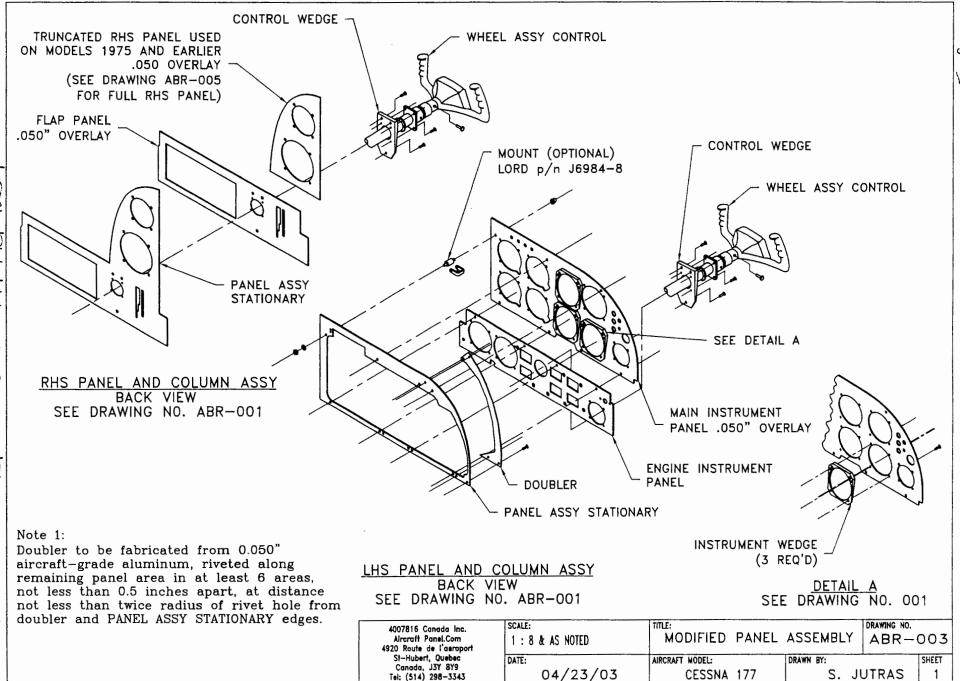

Tel: (514) 298-3343

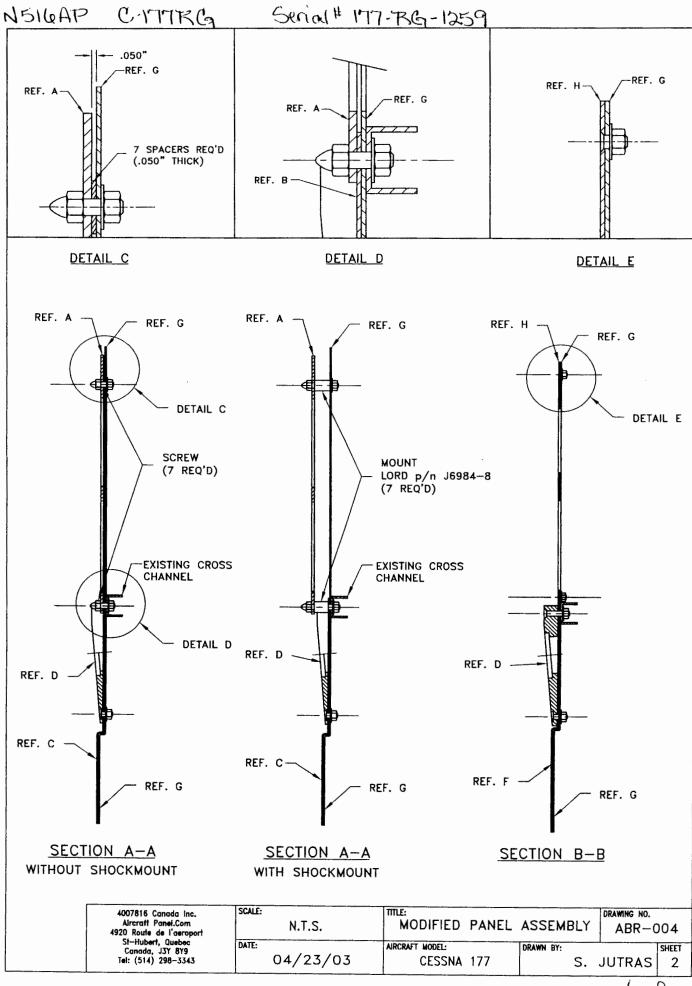

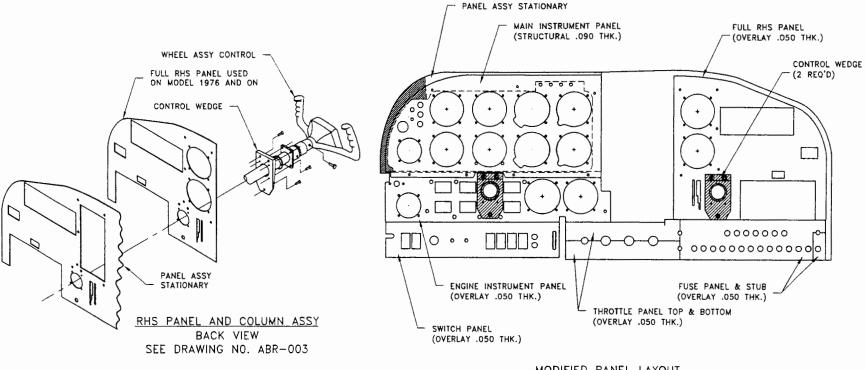

MODIFIED PANEL LAYOUT MODELS 1976 & ON

4007816 Canada Inc. Aircraft Panel.Com 4920 Route de l'aeroport	scale: 1 : 8 & AS NOTED	MODIFIED PANEL		DRAWING NO. ABR-	WING NO. BR-005	
St-Hubert, Quebec Canada, J3Y 8Y9	DATE:	AIRCRAFT MODEL:	DRAWN BY:		SHEET	
Tel: (514) 298-3343	04/23/03	CESSNA 177	S. JU	JTRAS	1	